



長岡京市公共下水道台帳（污水）

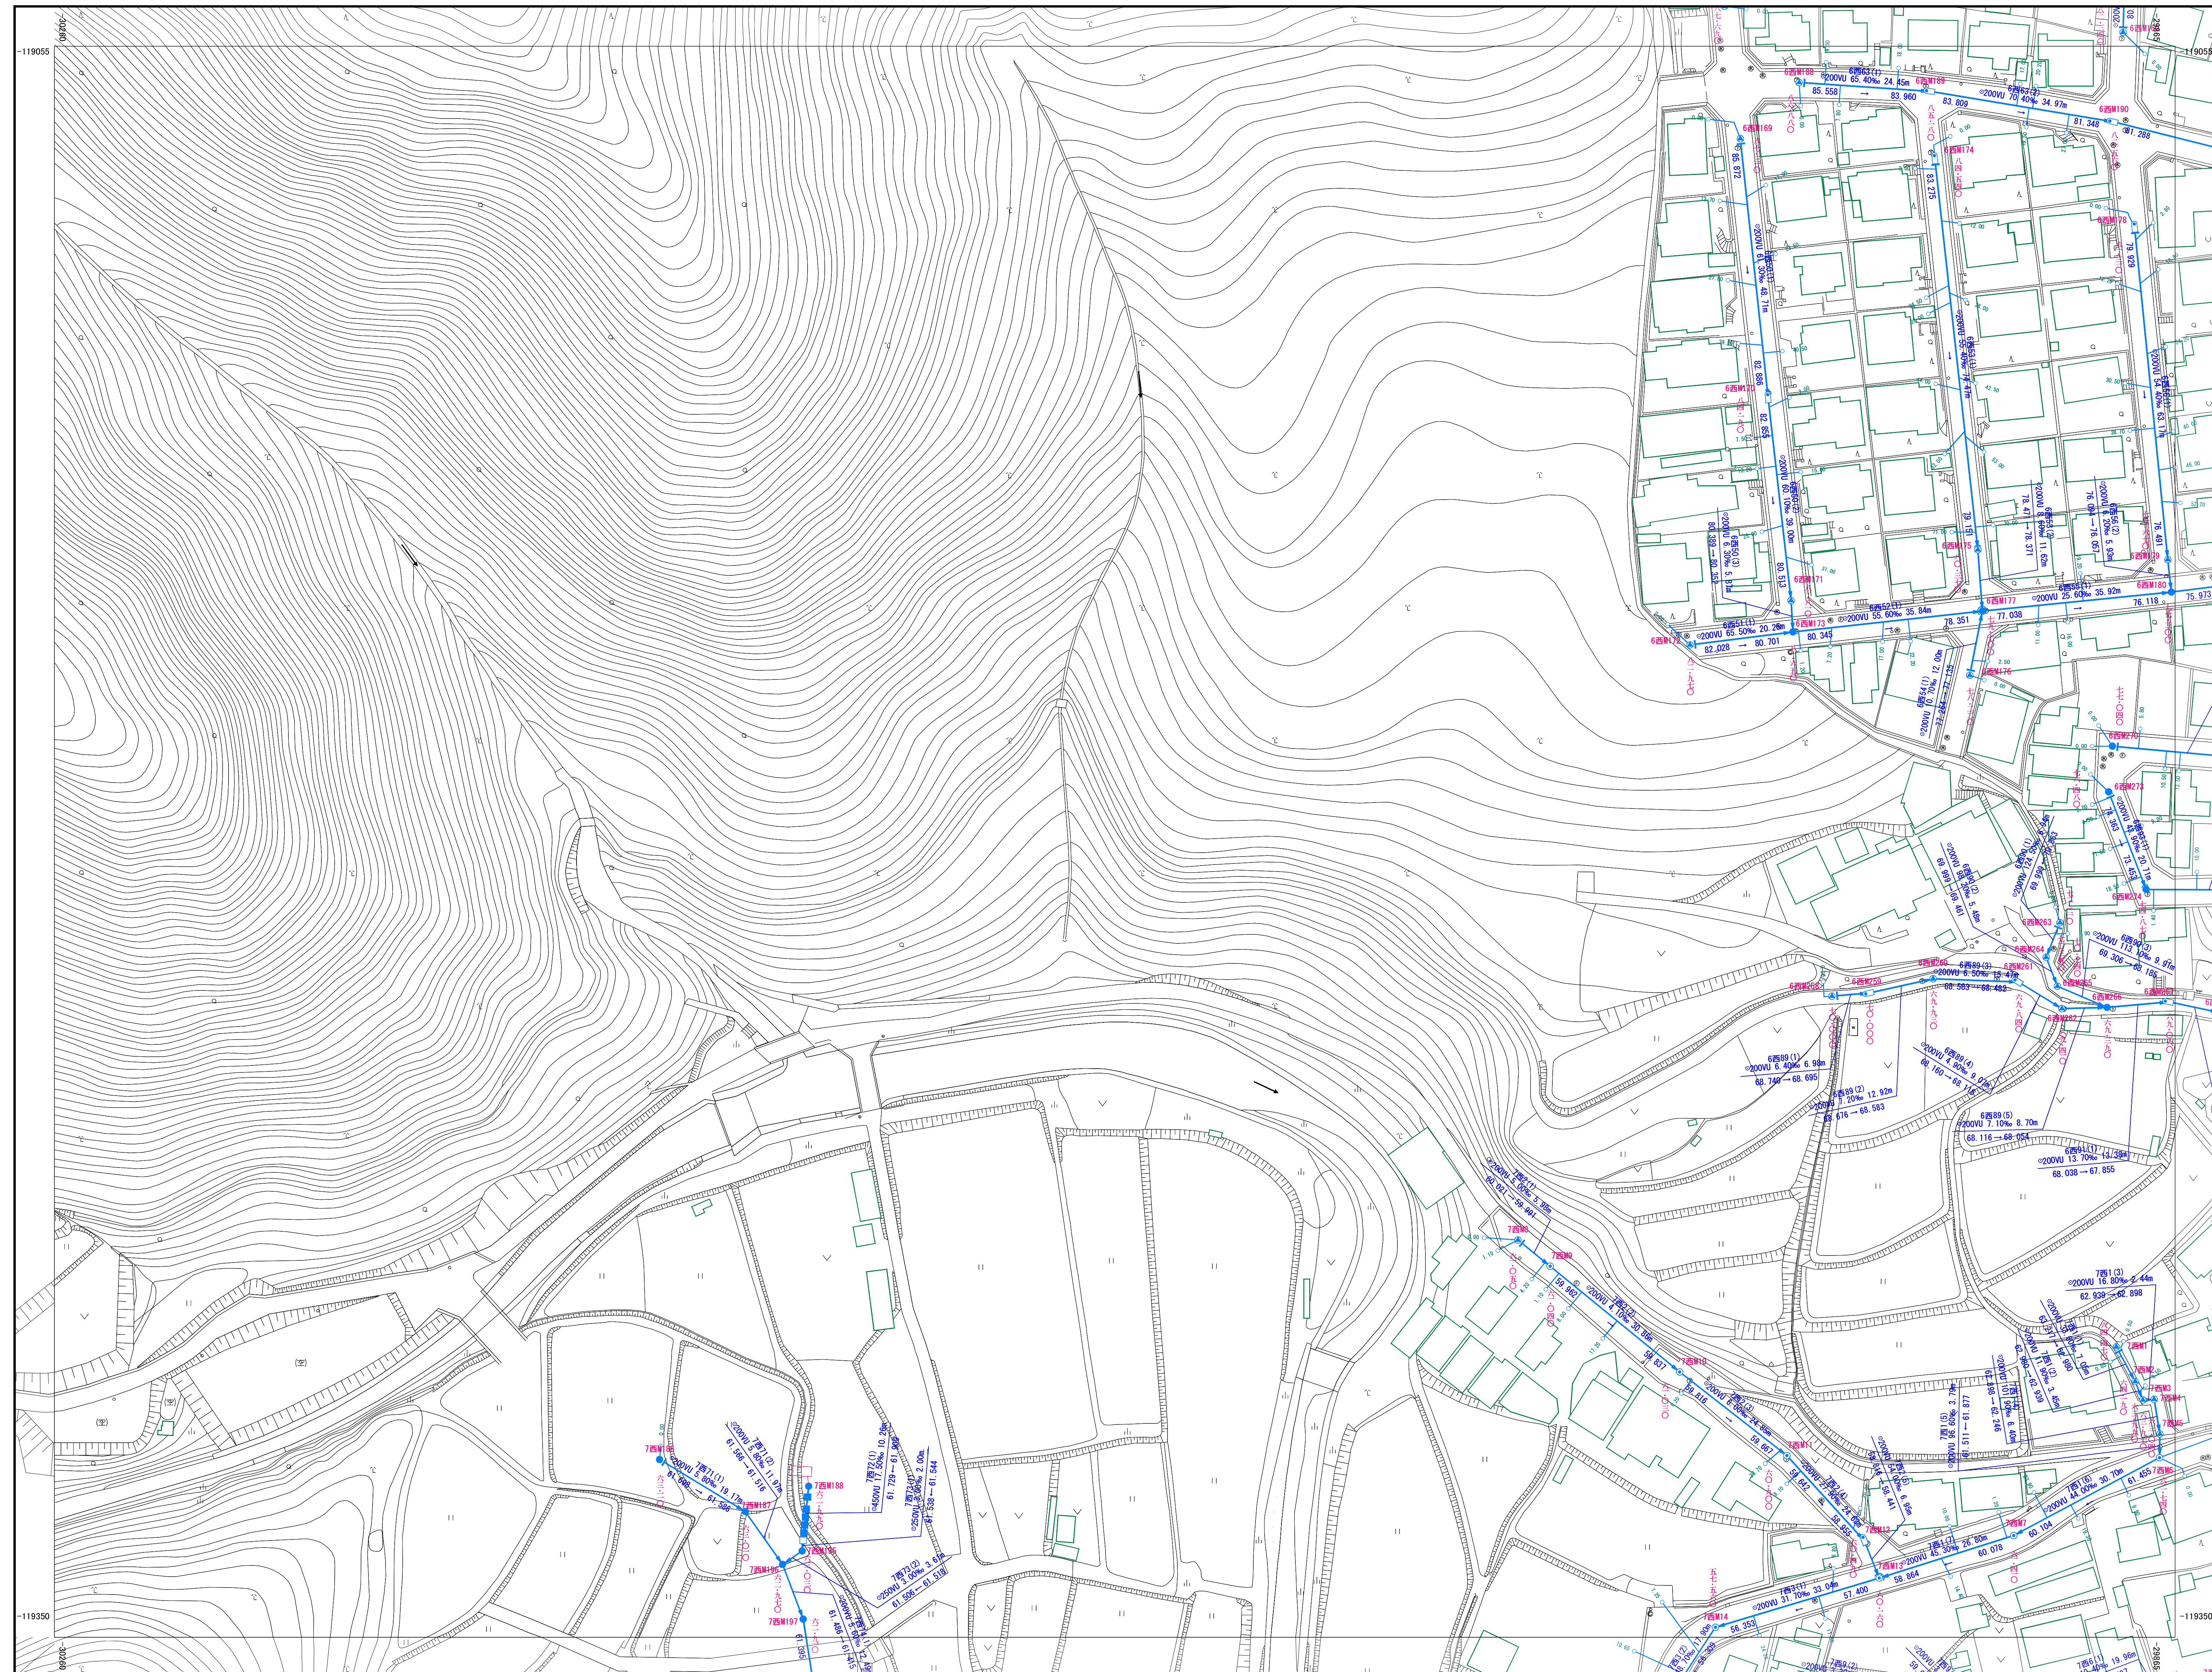

	C-11	C-12
	C-16	C-17
J-01	C-21	C-22

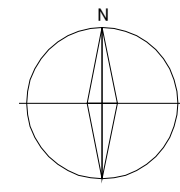

凡 例	
記 号	種 別
	0号マンホール
	1号マンホール
	2号マンホール
	3号マンホール
	4号マンホール
	特殊1号マンホール
	特殊2号マンホール
	特殊2号マンホール (高隆形)
	特殊3号マンホール
	塩ビマンホール
	レジンマンホール
	コンクリートマンホール
	1号汚水ます
	特殊マンホール
	横溝マンホール
	マンホールポンプ
	流域計測用 マンホール
	災害用マンホールトイレ
	貯留弁式マンホール
	幹線
	枝線
	圧送管(幹線)
	圧送管(枝線)
	取付管
	公共井

表示例

The diagram illustrates a water supply line configuration. A horizontal blue line represents the main supply line. On the left, a vertical red line labeled '上水道管' (Water supply pipe) connects to a blue circle labeled 'M1'. Below M1 is the text '上水道管番号' (Water supply pipe number). To the right of M1, the line is labeled '口圧 管径 200φJ 9.325'. Further right, a vertical red line labeled '下水側マンホール' (Sewer manhole) connects to a blue circle labeled 'M2'. Below M2 is the text '下水側マンホール番号' (Sewer manhole number). Between M1 and M2, the line is labeled '管径 1寸(1) 9.06φ' and '流氷方向' (Ice flow direction). Below the line, there are two labels: '上水道管圧高' (Water supply pipe pressure) and '下水側管圧高' (Sewer pipe pressure). At the bottom right, there is a label '新管マンホール' (New pipe manhole) and '通知距離' (Notification distance).